
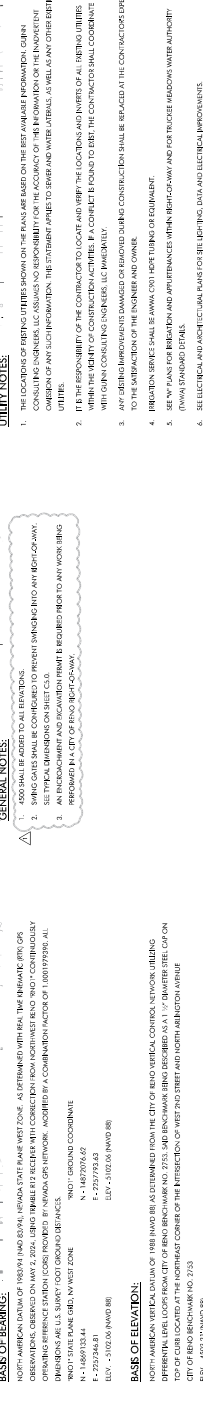









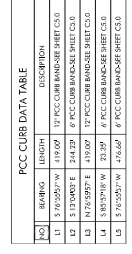


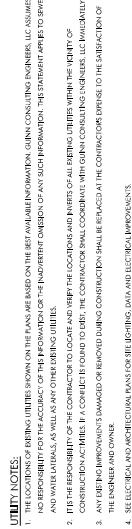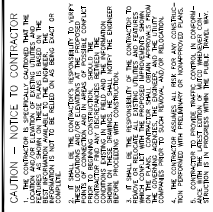 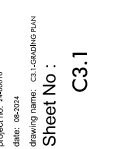

GENERAL NOTES:

1. 4500 SHALL BE ADDED TO ALL ELEVATIONS.
2. SWING GATES SHALL BE CONSIDERED TO PREVENT SWINGING INTO ANY RIGHT-OF-WAY.
3. SEE TYPICAL DIMENSIONS ON SHEET C3.0.


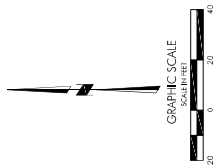

1. 4500 SHALL BE ADDED TO ALL ELEVATIONS.


3. ANY DISTINGUISHING IMPROVEMENTS, DAMAGED OR REMOVED DURING CONSTRUCTION SHALL BE REPLACED AT THE CONTRACTOR'S EXPENSE TO THE SATISFACTION OF THE ENGINEER AND OWNER.

3. ANY EXISTING IMPROVEMENTS DAMAGED OR REMOVED BY THE ENGINEER SHALL BE REPAIRED TO THE SATISFACTION OF THE ENGINEER AND OWNER.



CAUTION - NOTICE TO CONTRACTOR

1. THE CONTRACTOR IS SPECIFICALLY CAUTIONED THAT THE LOCATION AND/OR ELEVATION OF EXISTING UTILITIES AND FEATURES AS SHOWN ON THESE PLANS IS BASED ON THE BEST INFORMATION AVAILABLE TO THE ENGINEER. THE INFORMATION IS NOT TO BE RELIED ON AS BEING EXACT OR

2. IT SHALL BE THE CONTRACTOR'S RESPONSIBILITY TO VERIFY THESE LOCATIONS AND/OR ELEVATIONS AT THE PROPOSED POINTS OF CONNECTION AND IN AREAS OF POSSIBLE CONFLICT PRIOR TO BEGINNING CONSTRUCTION. SHOULD THE CONTRACTOR FIND ANY DISCREPANCIES BETWEEN THE CONDITIONS EXISTING IN THE FIELD AND THE INFORMATION SHOWN ON THESE DRAWINGS, HE SHALL NOTIFY THE ENGINEER IMMEDIATELY BY TELEPHONE AND CONFIRM IN WRITING.

3. IF SMALL, THE RESPONSIBILITY OF THE CONTRACTOR TO REMOVE OR RELOCATE ALL EXISTING UTILITIES AND FEATURES WHICH COMPLY WITH THE PROPOSED IMPROVEMENTS SHOWN ON THE PLANS, CONTRACTOR SHALL OBTAIN APPROVAL FROM THE GOVERNING AGENCIES, THE ENGINEER, AND THE UTILITY COMPANIES PRIOR TO SUCH REMOVAL AND/OR RELOCATION.

4. THE CONTRACTOR ASSUMES ALL RISK FOR ANY CONTROLS NOT PERFORMED WITH THE PRIMARY OR NONAPPROVED PLANS.

5. CONTRACTOR TO PROVIDE TRAFFIC CONTROL IN CONFORMANCE WITH THE LATEST EDITION OF MUTCD. BARRIER CON-



ISSUE FOR PERMIT 09/06/2024		
--------------------------------	--	--

Revisions :
 09/15/2024 WILSON-02386 - REVIEW COMMENTS
 10/11/2024 WILSON-02386 - REVIEW COMMENTS

Sheet Title :
GRADING PLAN






